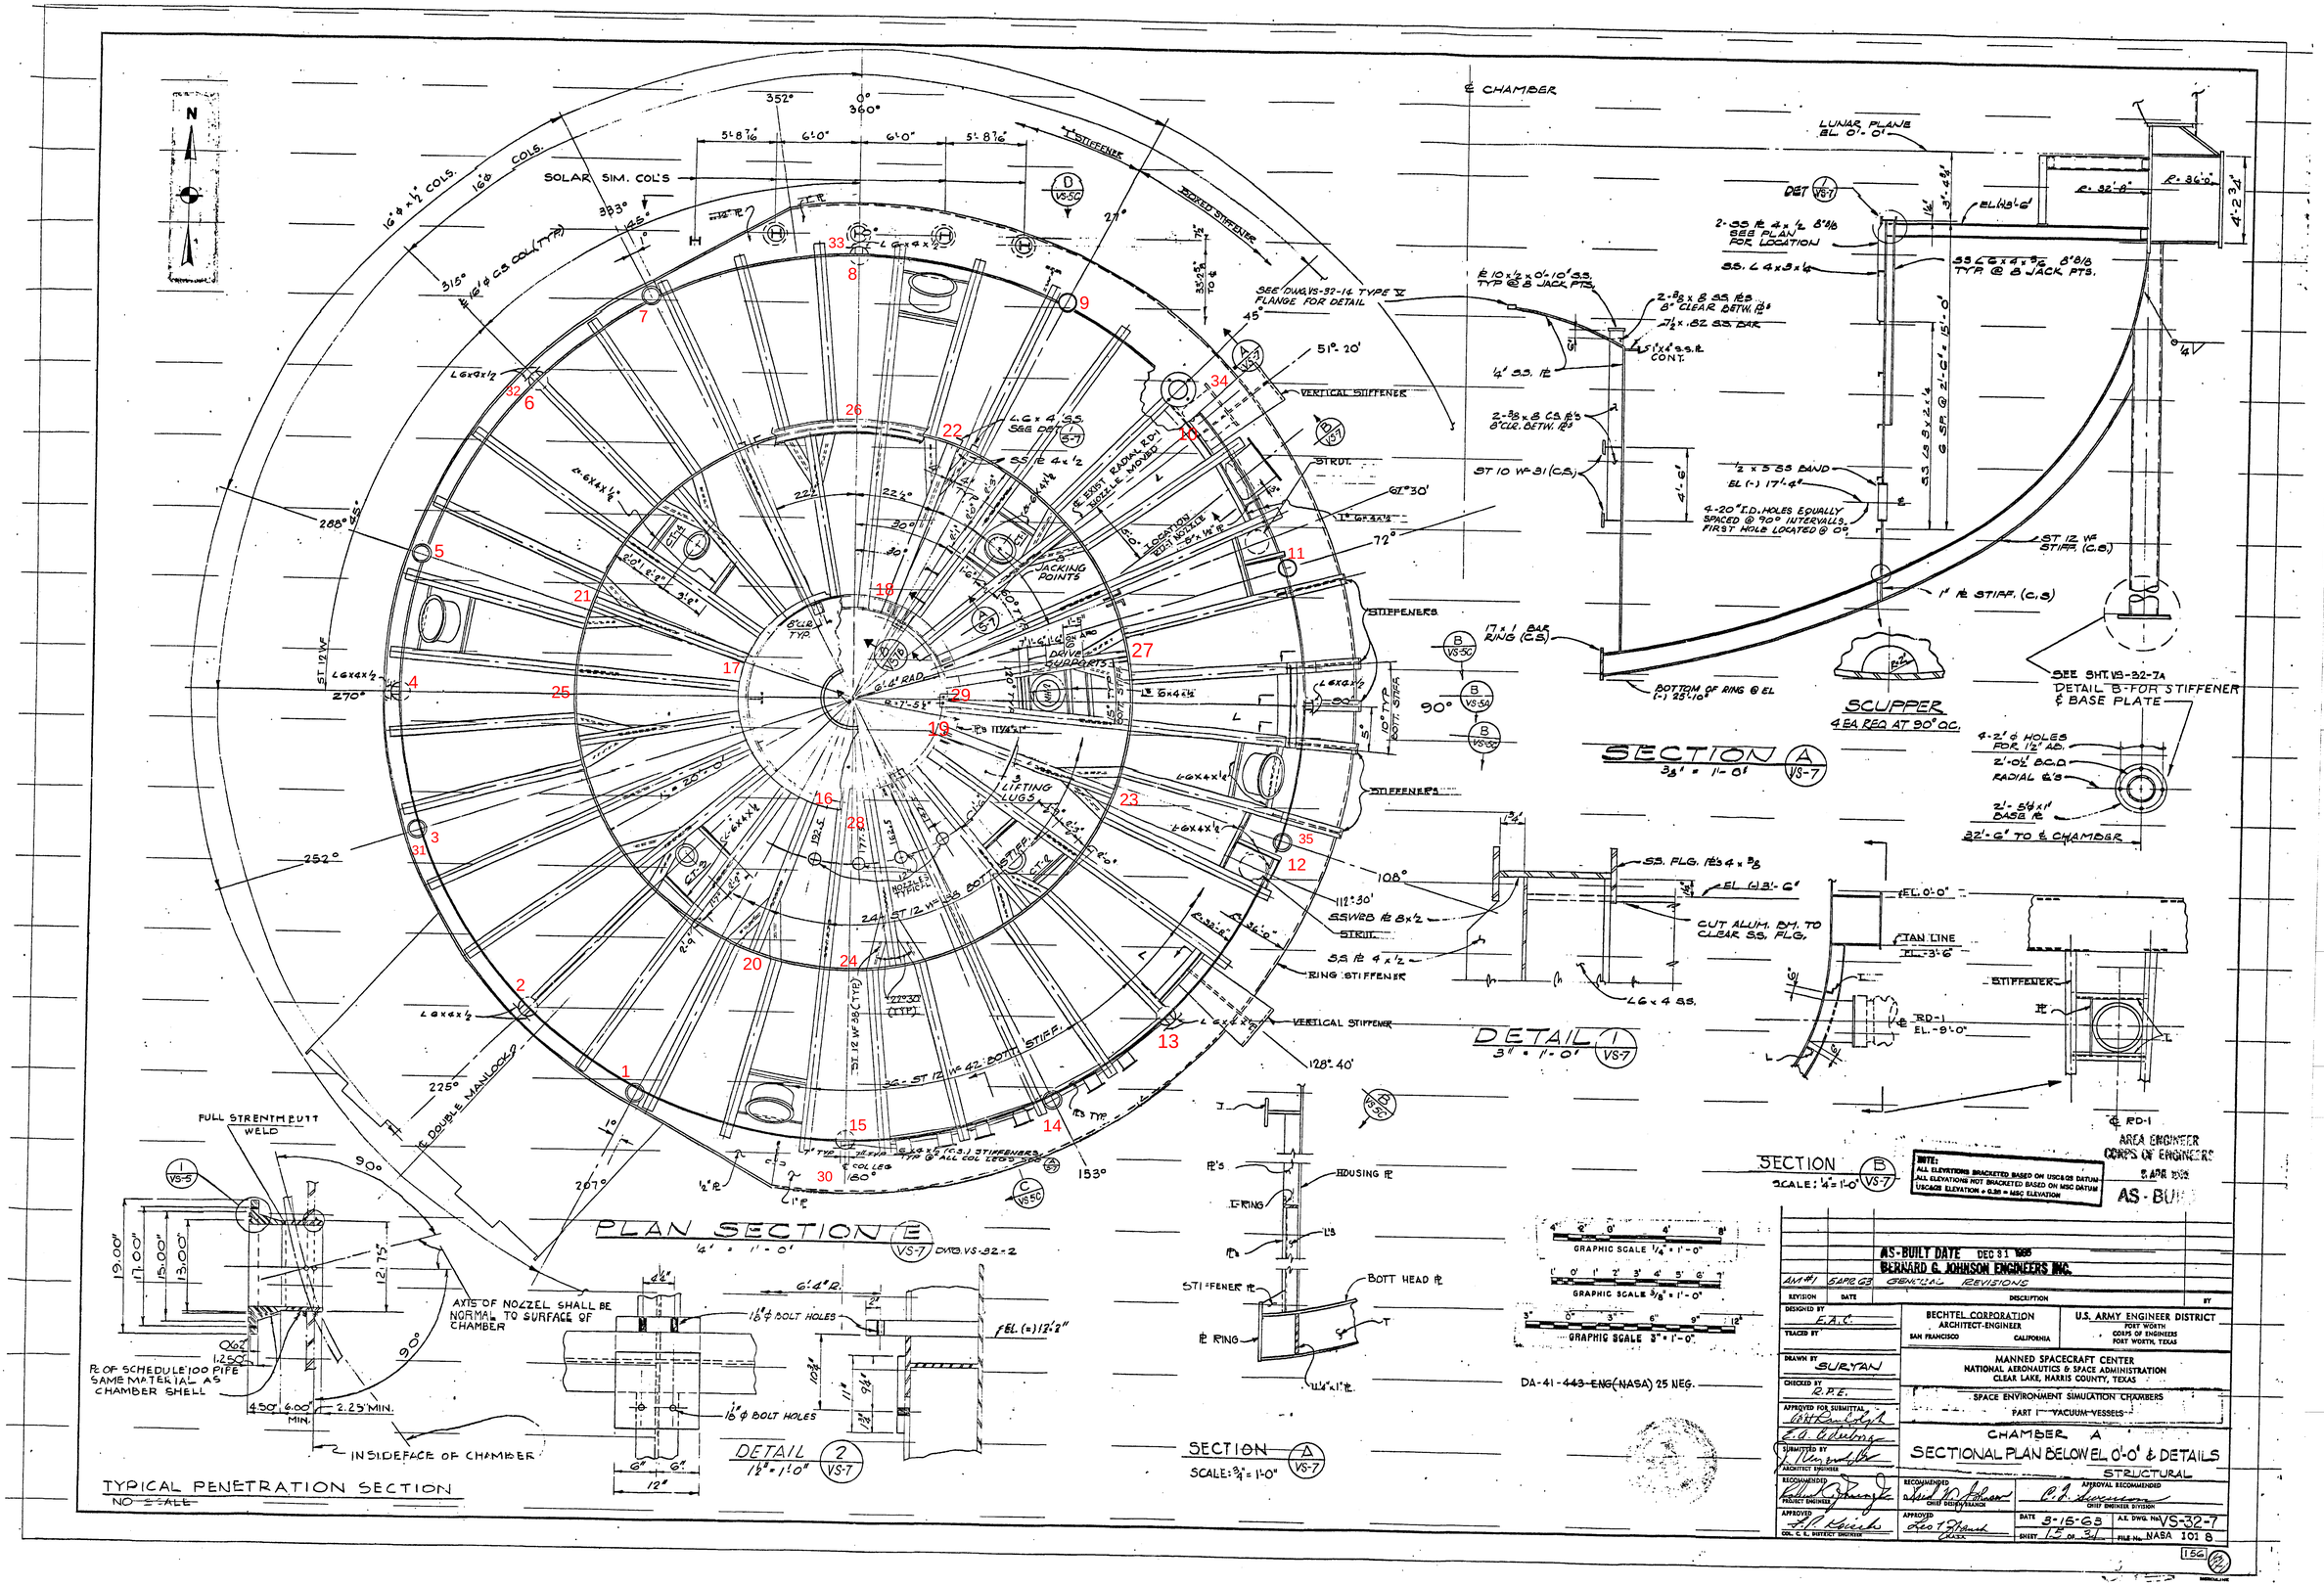

AS-BUILT DATE DEC 31 1965
BERNARD G. JOHNSON ENGINEERS INC.

REVISION	DATE	DESCRIPTION	BY
AM #1	5 APR 63	GENERAL REVISIONS	

DESIGNED BY E.A.C.
TRACED BY
DRAWN BY SURYAN
CHECKED BY R.P.E.
APPROVED FOR SUBMITTAL
SUBMITTED BY
ARCHITECT ENGINEER
RECOMMENDED
PROJECT ENGINEER
APPROVED
COL. C. E. DISTRICT ENGINEER

BECHTEL CORPORATION
ARCHITECT-ENGINEER
SAN FRANCISCO CALIFORNIA

U.S. ARMY ENGINEER DISTRICT
FORT WORTH
CORPS OF ENGINEERS
FORT WORTH, TEXAS

MANNED SPACECRAFT CENTER
NATIONAL AERONAUTICS & SPACE ADMINISTRATION
CLEAR LAKE, HARRIS COUNTY, TEXAS

SPACE ENVIRONMENT SIMULATION CHAMBERS
PART I VACUUM VESSELS

CHAMBER A
SECTIONAL PLAN BELOW EL 0'-0" & DETAILS
STRUCTURAL

RECOMMENDED
CHIEF DESIGN BRANCH
APPROVAL RECOMMENDED
CHIEF ENGINEER DIVISION
APPROVED
CHAIRMAN
DATE 3-15-63
SHEET 15 OF 34
A.E. DWG. No. VS-32-7
FILE No. NASA 101 8

156